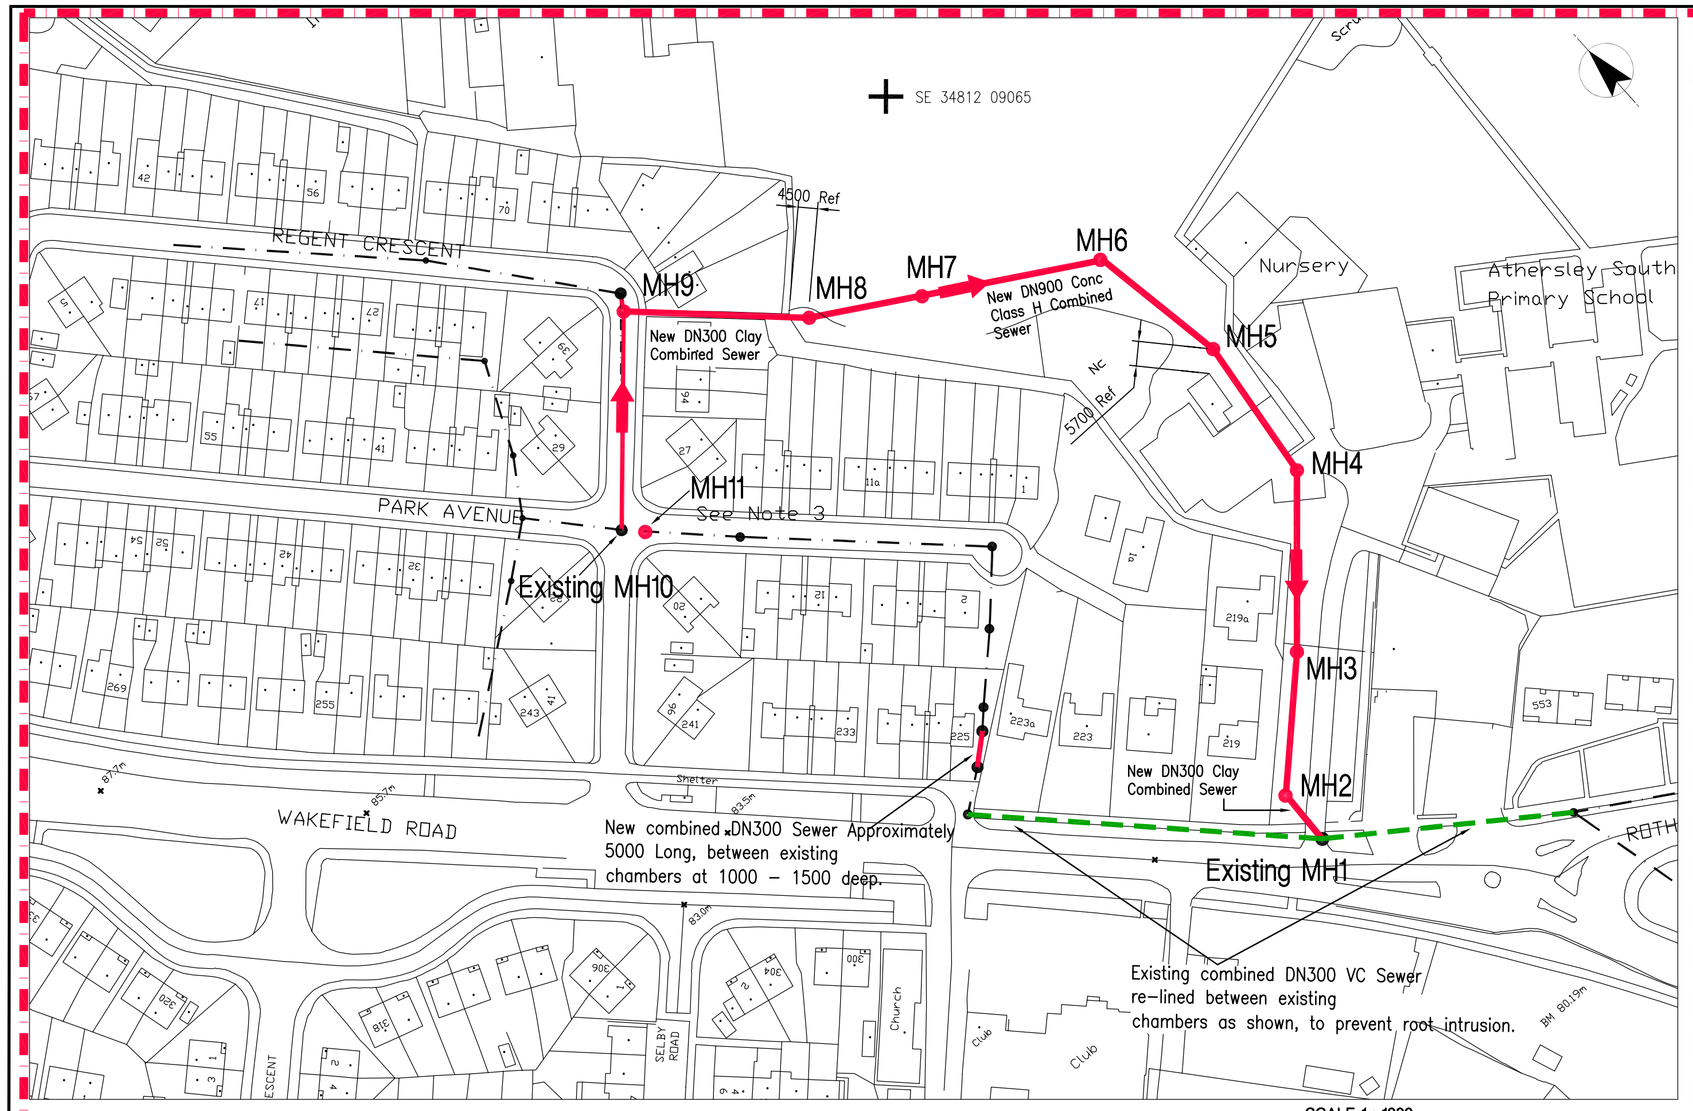

SITE PLAN

B

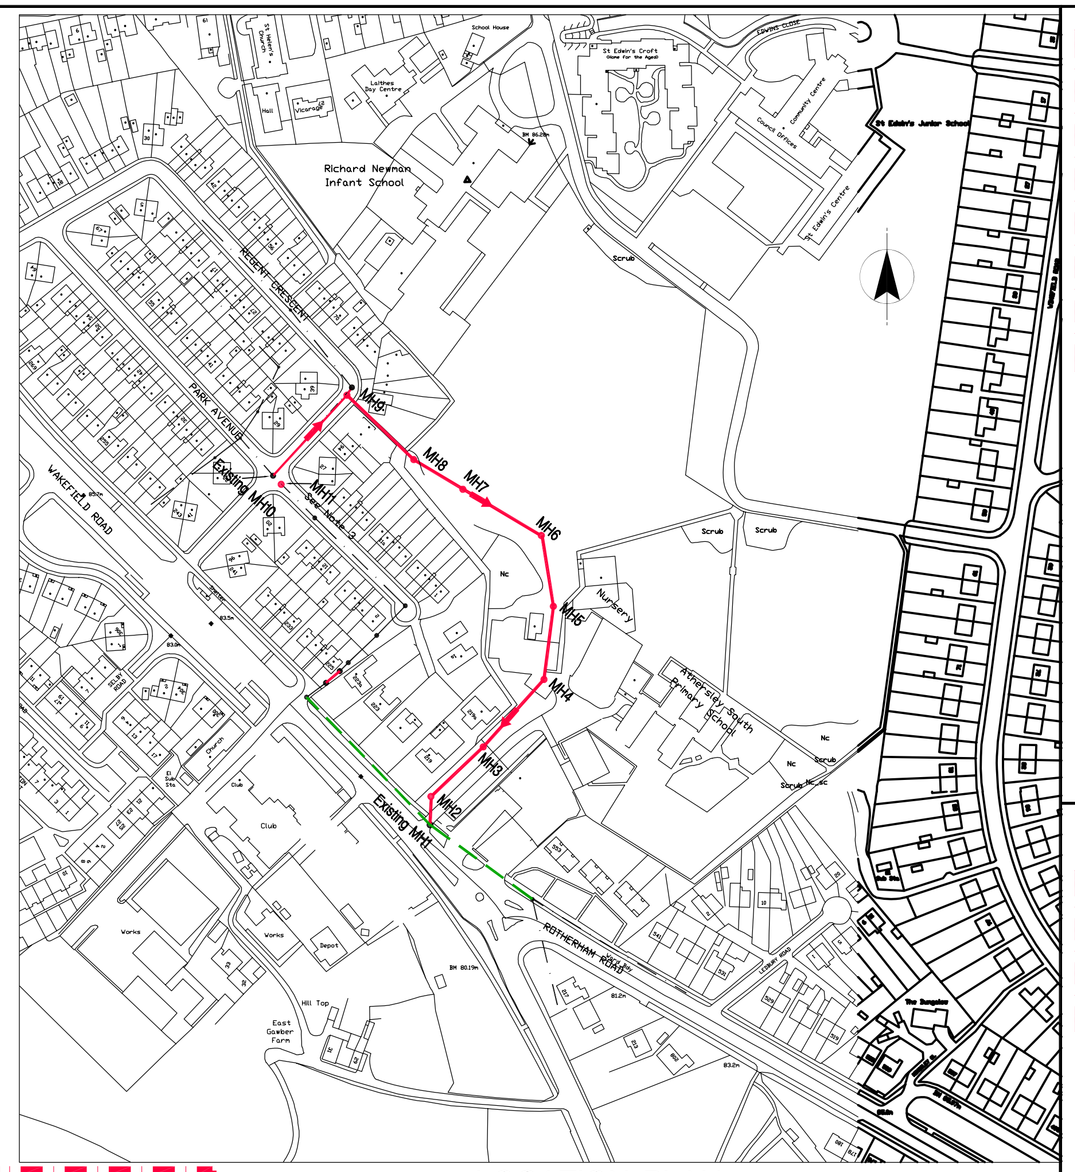

LOCATION PLAN

SCALE 1 : 2000

m 100 0 100 m

NOTES

LEGEND

For Line styles and colours use Appendix VI – Standard symbols for use on drawings, Sewers for adoption 6th edition.

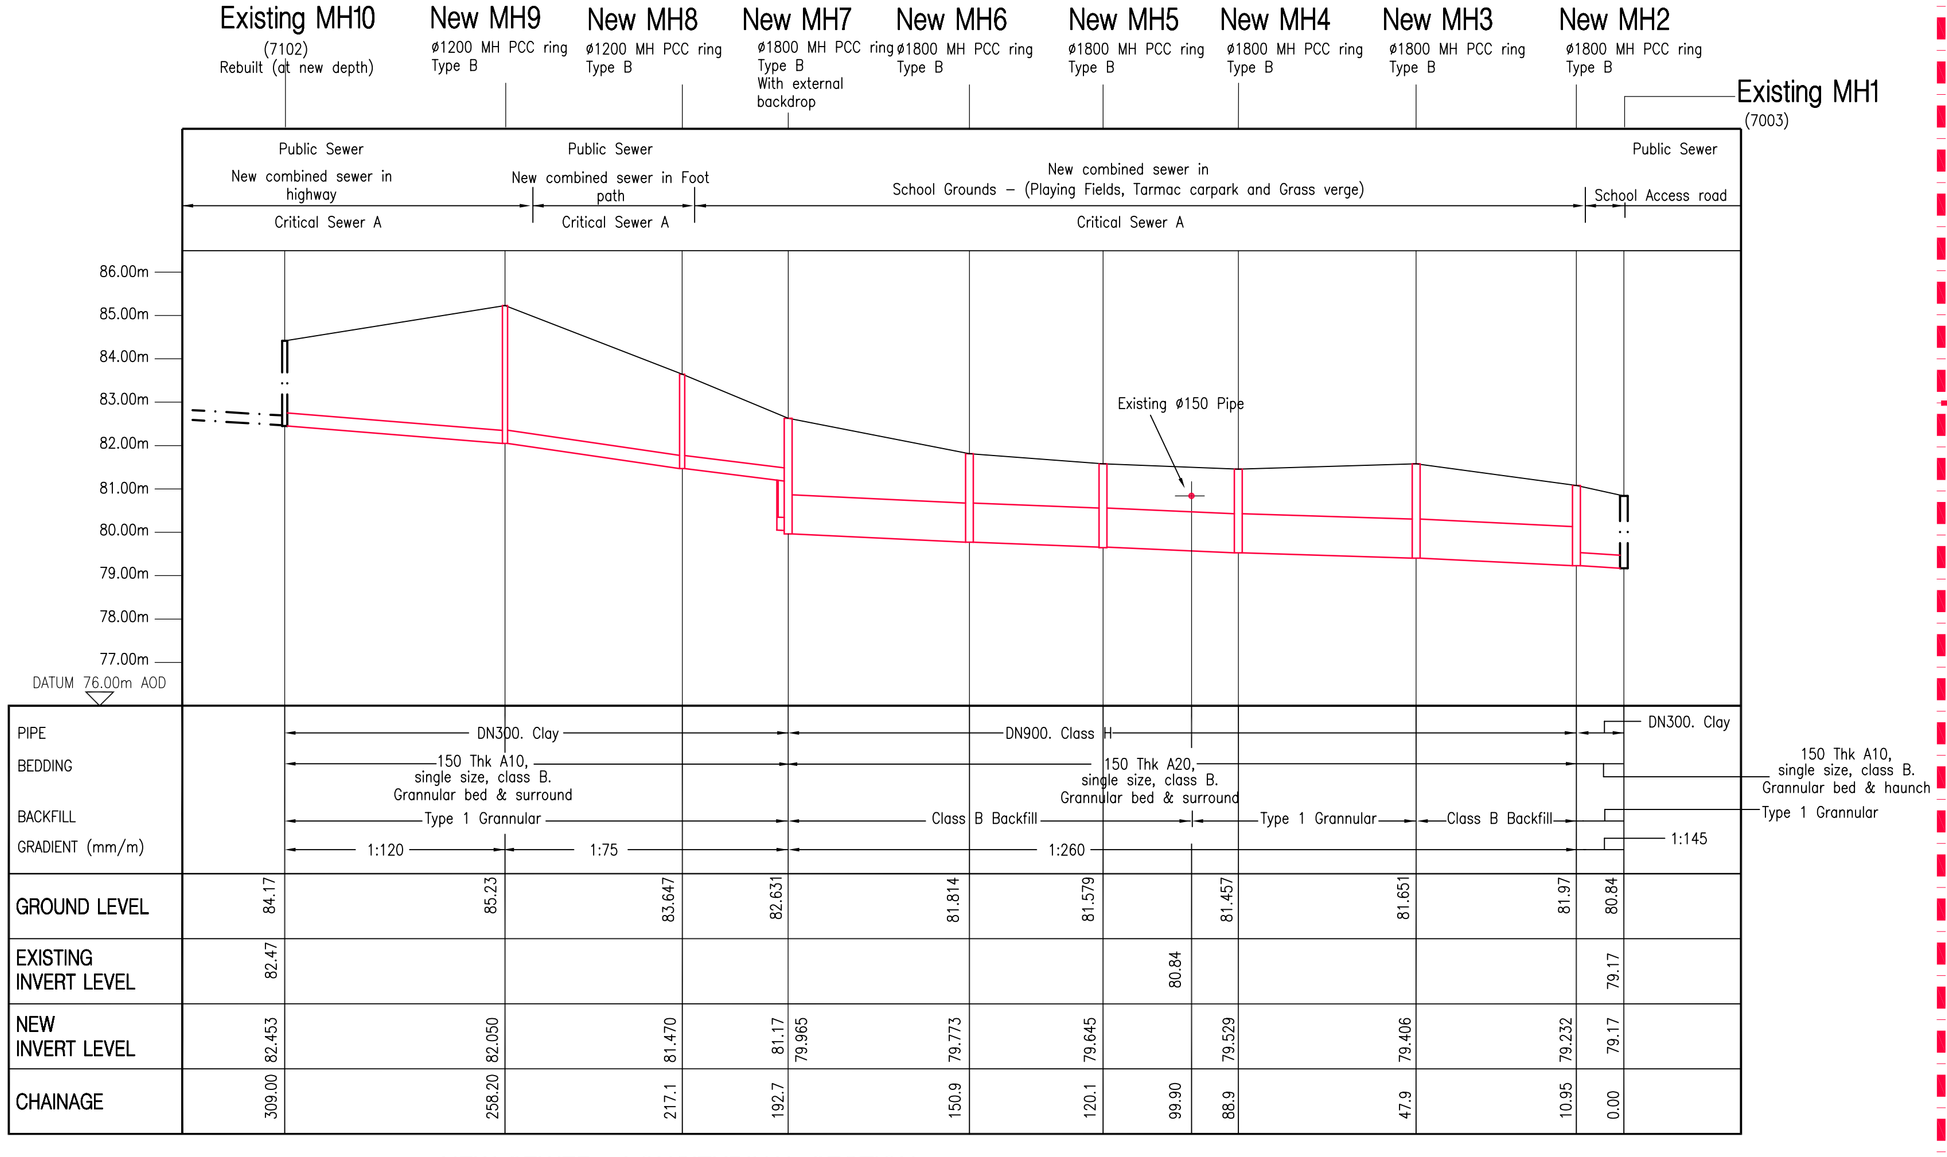

NEW SEWER - LONGITUDINAL SECTION SCALE HORIZ – 1:1000, VERT 1:100

C

A

Current Issue Information
Proposed or As Built
Date in Ground

Address of Site
Title of As Built

Yorkshire Water Agreement Number

Developers Name

S104 Proposal
Date in Ground - 22/05/07

Another Street, Townsville

Plan and Longitudinal Section of New Sewers

H-3-261-877

Developers Ltd.